

Form-4
(Prescribed under rule-5)
Government of Rajasthan



REGISTRATION & LICENCE TO WORK A FACTORY

Registration No.:- RJ/32454

Fees Rs.:- 2700/- per year

Application No.:- R-44779/CIFB/2018

Licence is hereby granted to M/s KIRAN INFRA ENGINEERS LTD valid only for the premises described below for use as factory employing not more than 50 persons on any day during the year and using motive power not exceeding 45 H.P subject to the provisions of the Factories Act, 1948 and the rule made there under.

This licence shall remain in force till the 31st day of March 2019

Date:- 23/07/2018





Chief Inspector of Factories and Boilers
Rajasthan, Jaipur

Description of the licensed premises

M/s KIRAN INFRA ENGINEERS LTD

The licenced premises shown on Plan No. P-36634/CIFB/2018. Date 11.07.2018 are situated in SP 35, RIICO IND AREA KALADERA, JAIPUR- 303108 and consist of GRINDING & FABRICATION OF IRON GRIDER BRIDGES.

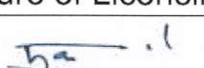Date of Renewal	Date of Expiry	Signature of Licensing Authority
23/07/2018	31/03/2028	 Chief Inspector of Factories and Boilers, Jaipur

This is a computer generated certificate and bears scanned signature. No physical signature is required on this license. You can verify this license by visiting www.rajfab.rajasthan.gov.in and entering Application No./ID after clicking the link for verification on the page.

Government of Rajasthan
Factories and Boilers Inspection Department
6-C, Jhalana Institutional Area, Jaipur 302004

Application Id:- P-36634/CIFB/2018

Dated:- 11/07/2018

Plan No.:- P- JPR-2157

KIRAN INFRA ENGINEERS LTD
SP 35, RIICO IND AREA KALADERA, JAIPUR
Chomu, Jaipur


Sub:- Approval of Factory Building drawings

The details of your factory as per application, drawings and documents are shown below:-

Manufacturing Process	GRINDING AND FABRICATION OF IRON GRIDER BRIL
Type	2m(i)
Category	Non Hazardous
Workers	125


Drawings of your factory are approved under Section 6 of The Factories Act, 1948 with the following conditions:-

1. Certificate of Stability obtained from a competent person shall be submitted as per Rule 3C of Rajasthan Factories Rules, 1951.
2. Disposal of the trade waste effluents shall be as per the provisions of Rule 17 of the Rajasthan Factories Rules, 1951.
3. Disposal of the waste from latrines & urinals shall be as per the provisions of Section 19 of Factories Act, 1948.
4. Drinking water facilities should be provided as per provisions of Section 18 of Factories Act, 1948.
5. Fire fighting arrangement should be provided as per provisions of Section 38 of Factories Act, 1948 and Rule 63 of Rajasthan Factories Rules, 1951.
6. Drawings are approved for 125 male and 0 female (Total - 125) workers only.

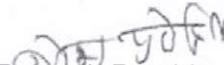

Ramesh Purohit

Dy. Chief Inspector Factories and Boilers
Jaipur

This is a computer generated certificate and bears scanned signature. No physical signature is required on this approval. You can verify this approval by visiting www.rajfab.rajasthan.gov.in and entering Application No./ID after clicking the link for verification on the page.

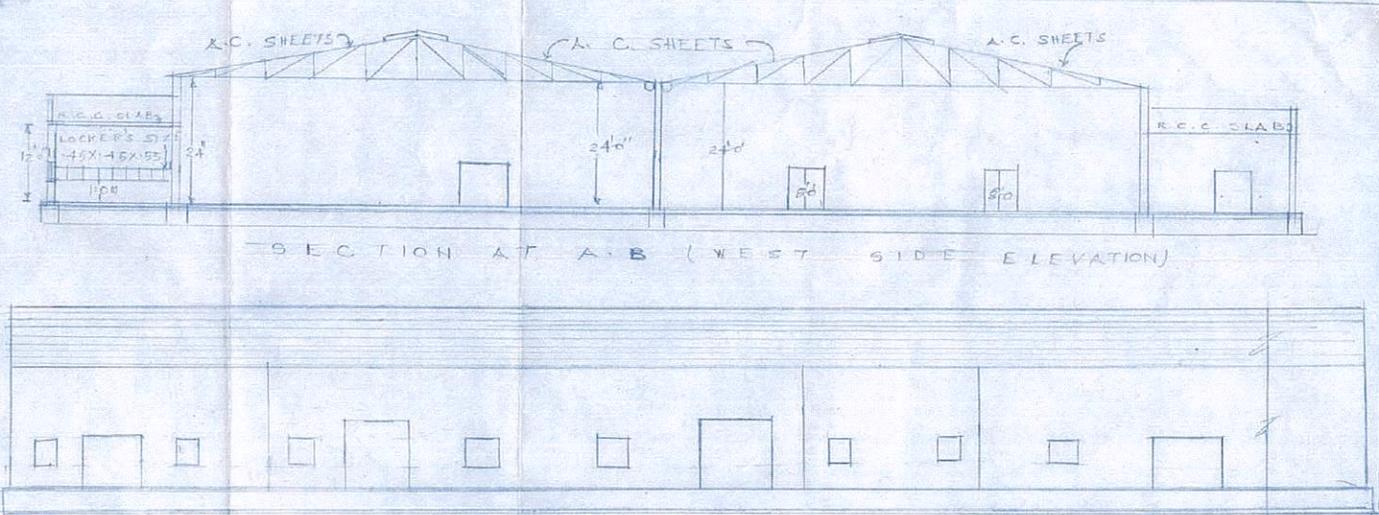


SECTION AT A-B (WEST SIDE ELEVATION)

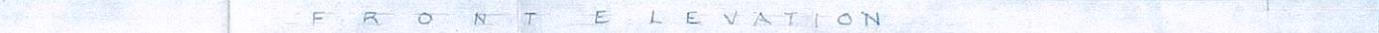

FRONT ELEVATION


SCHEDULE OF JOINERY

G GATE	75'0" WIDE
D. DOOR	10'0" X 10'0"
D. A	5'0" X 8'0"
D. B	4'0" X 7'0"
W. WINDOW	4'0" X 4'0"
W. WINDOW	3'0" X 4'0"
VENTILATOR	5'0" X 1'0"

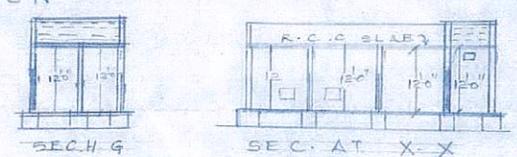

SEC. H G

SEC. AT X-X

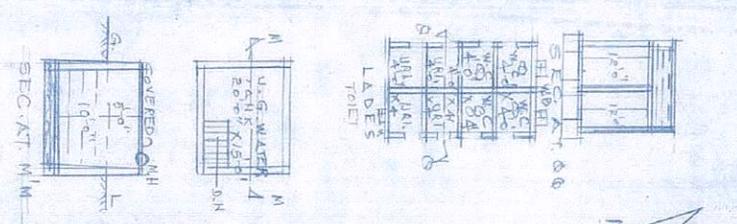


SEC. AT M-M

SHEET NO.1 (PROPOSED)

M/S KIRAN INFRA ENGINEERS LTD.
PNO SP 35 AT INDUSTRIAL AREA
DISTT. JAIPUR (RAJ)

For Kiran Infra Engineers
KALADEKA
DISTT. JAIPUR (RAJ)

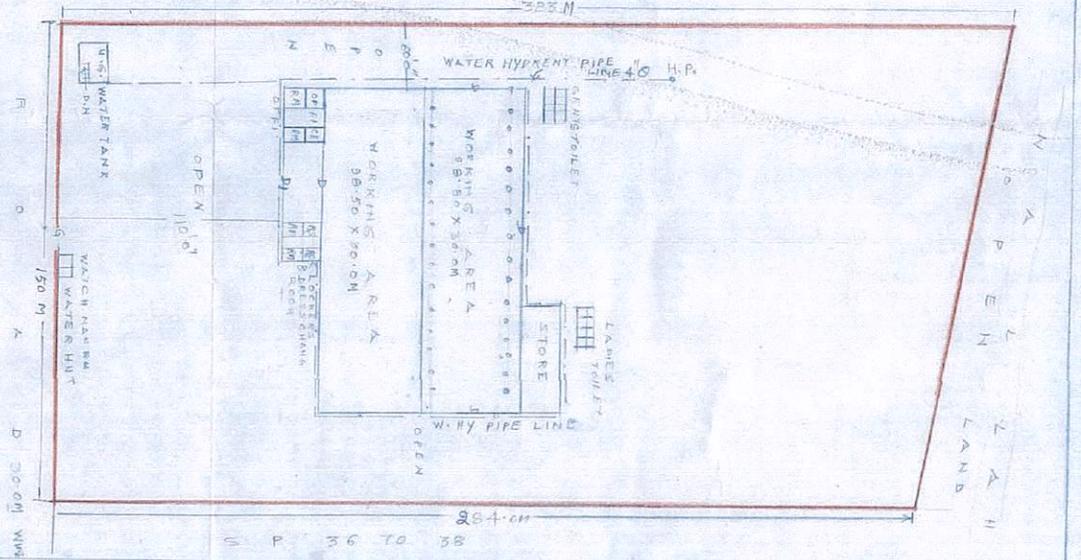

SITE PLAN

SCALE: 1:500
FACTORY AREA SHOWN IN RED

M/S KIRAN INFRA ENGINEERS LTD.
PNO SP 35 AT INDUSTRIAL AREA
DISTT. JAIPUR (RAJ)

